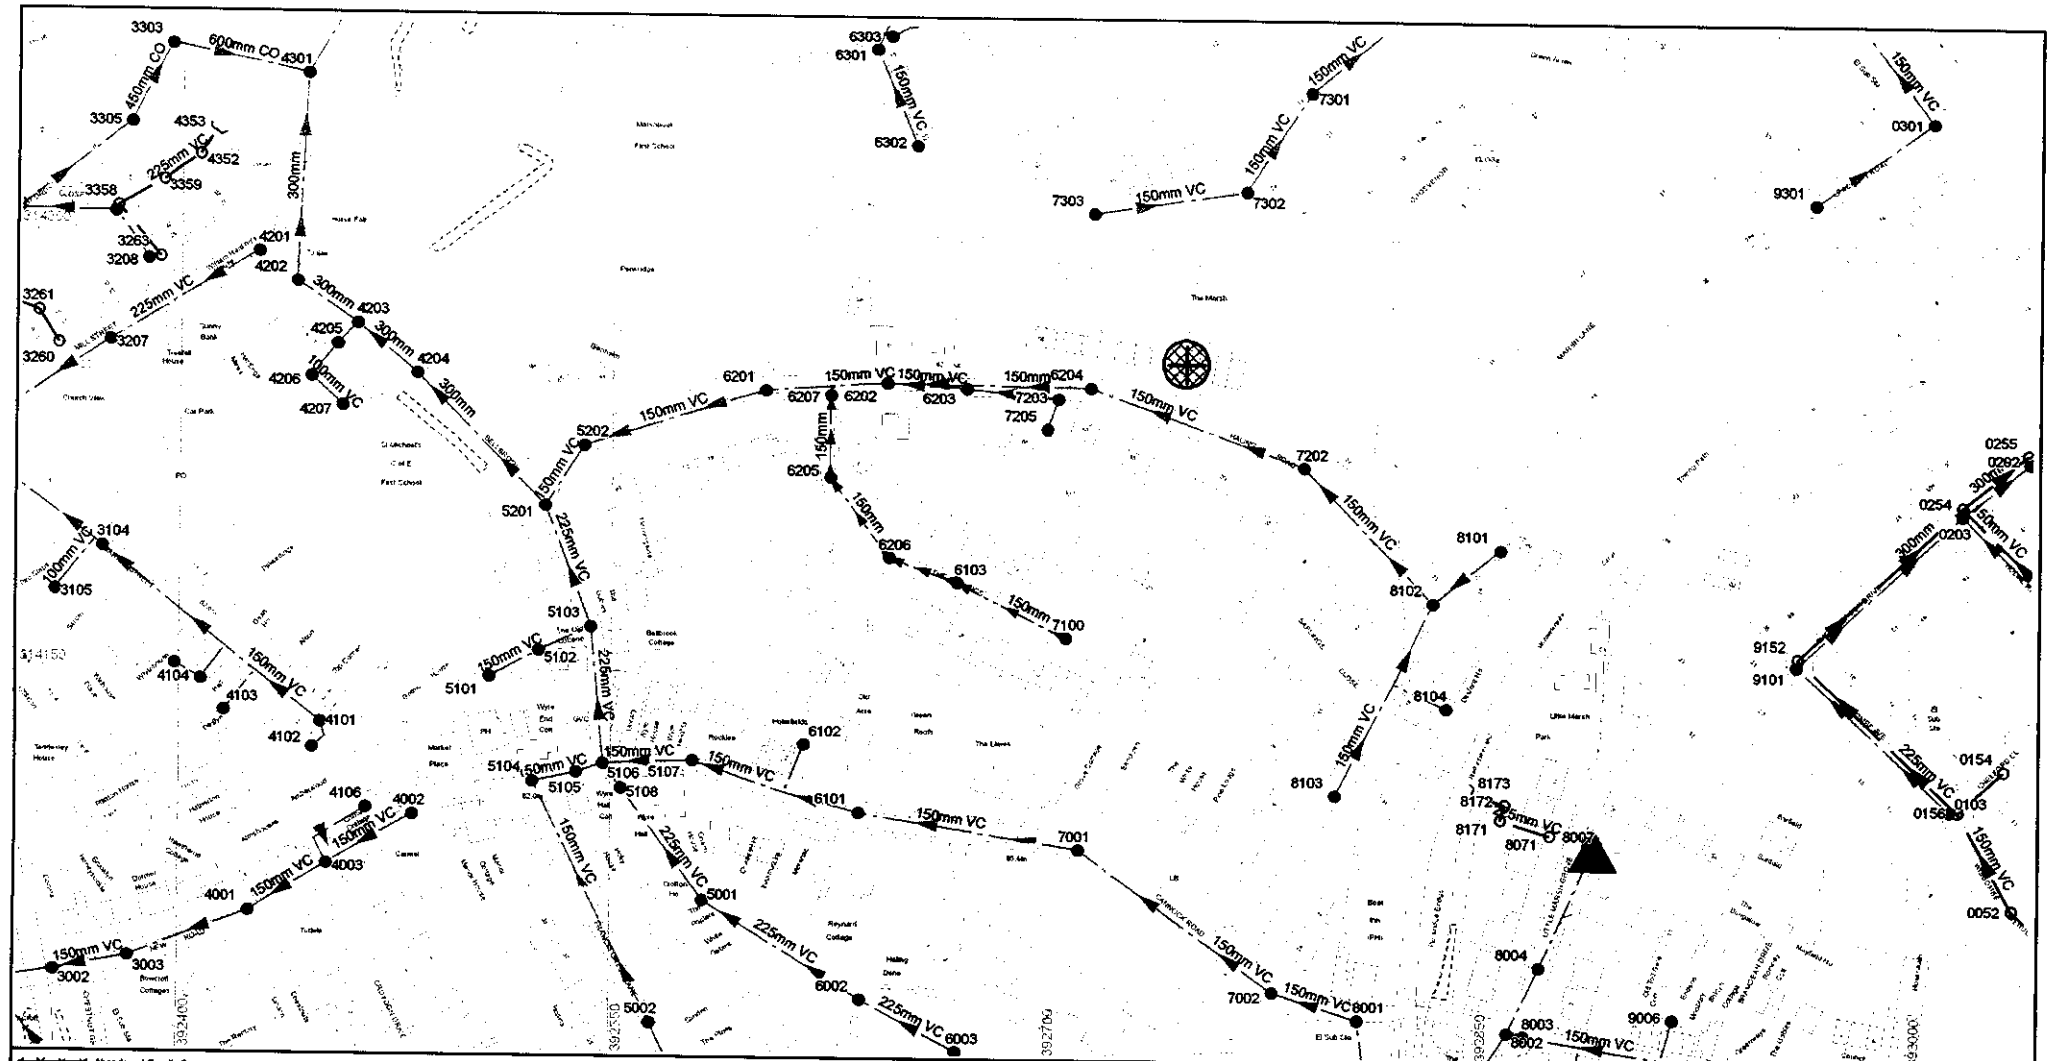

- Abandoned Gravity Sewer
- Private Combined Gravity Sewer
- Private Foul Gravity Sewer
- Private Surface Water Gravity Sewer
- Public Combined Gravity Sewer
- Public Foul Gravity Sewer
- Public Surface Water Gravity Sewer
- Trunk Combined Gravity Sewer
- Trunk Foul Use Gravity Sewer
- Trunk Surface Water Gravity Sewer
- Combined Use Pressurised Sewer
- Foul Use Pressurised Sewer
- Surface Water Pressurised Sewer
- Highway Drain
- Combined Lateral Drain (SS)
- Foul Lateral Drain (SS)
- Surface Water Lateral Drain (SS)

All Private Sewers are shown in magenta
All section 104 sewers are shown in green

- Culverted Watercourse
- Cable, Earthing
- Cable Junction
- Cable, Optical Fibre/Instrumentation
- Cable, Low Voltage
- Cable, High Voltage
- Cable, Other
- Housing, Building
- Housing, Kiosk
- Disposal Site
- Sewage Treatment Works
- Housing, Other
- Pipe Support Structure
- Sewage Pumping Facility
- Sewer Facility Connection Inlet / Outlet
- Blind Shaft
- Combined Use Manhole
- Flushing Chamber
- Foul Use Manhole
- Grease Trap
- Head Node
- Hydrobrake
- Lamphole
- Outfall
- Overflow
- Penstock
- Petrol Interceptor
- Sewer Blockage
- Sewer Collapse
- Sewer Chemical Injection Point
- Sewer Junction
- Sewerage Air Valve
- Sewerage Hatch Box Point
- Sewerage Isolation Valve
- Soakaway
- Surface Water Manhole
- Vent Column
- Waste Water Storage
- SSSI Area
- Access Right
- Pre-1937 Properties

MATERIALS

- NONE
AC - ASBESTOS CEMENT
BR - BRICK
CC - CONCRETE BOX CULVERT
CI - CAST IRON
CO - CONCRETE
CSB - CONCRETE SEGMENTS (BOLTED)
CBU - CONCRETE SEGMENTS (UNBOLTED)
DI - DUCTILE IRON
GRC - GLASS REINFORCED CONCRETE
GRP - GLASS REINFORCED PLASTIC
MAC - MASONRY IN REGULAR COURSES
MAR - MASONRY RANDOMLY COURSED
PE - POLYETHLENE
PF - PITCH
PP - POLYPROPYLENE
PSC - PLASTIC STEEL COMPOSITE
PVC - POLYVINYL CHLORIDE
RPM - REINFORCED PLASTIC MATRIX
SI - SPUN (GREY) IRON
ST - STEEL
U - UNKNOWN
VC - VITRIFIED CLAY
XXX - OTHER

CATEGORIES

W - WEIR
C - CASCADE
DB - DAMBOARD
SE - SIDE ENTRY
FV - FLAP VALVE
BD - BACK DROP
S - SIPHON
HD - HIGHWAY DRAIN
S104 - SECTION 104

SHAPE

C - CIRCULAR
E - EGG SHAPED
O - OTHER
R - RECTANGLE
S - SQUARE
T - TRAPEZOIDAL
U - UNKNOWN

PURPOSE

C - COMBINED
E - FINAL EFFLUENT
F - FOUL
L - SLUDGE
S - SURFACE WATER

N W E S

Severn Trent Water

Severn Trent Water Limited
Wedgewoods Road
Edgbaston
Birmingham
B16 6DD
Telephone: 0845 601 0616

SEWER RECORD

O/S Map scale: 1:1750

Date of Issue: 30.11.09

This map is centred upon:
O / S Grid reference:

x : 392693

y : 314195

Do not scale off drawing:

Disclaimer:

1. This plan and any information supplied with it is furnished as a general guide, is only valid at the date of issue and no warranty as to its correctness is given or implied. In particular this plan and any information shown on it must not be relied upon in the event of any development or works (including but not limited to excavations) in the vicinity of SEVERN TRENT WATER assets or for the purposes of determining the suitability of a point of connection to the sewerage or distribution systems.

2. Reproduction by permission of Ordnance Survey on behalf of HMSO. © Crown Copyright and database right 2004. All rights reserved.

   Ordnance Survey licence number 100018202.

3. Document users other than SEVERN TRENT WATER business users are advised that this document is provided for reference purpose only and no further copies should be made from it.